


» FOCUSED INTERIORS

21-11-02 - [OMAR + MIRIAM] - 61-12500 MCNEELY DRIVE, RICHMOND, BC V6V 2S4 CANADA

DESIGN DIRECTION PACKAGE

2021.11.05

UPDATED 2021.11.10

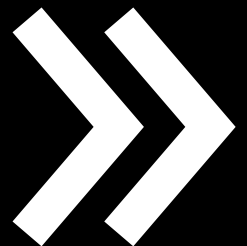




FOCUS

Quality. Durable. Resilient Fixtures, Finishes, Equipment.
Warm, bright, inviting space with pops of colour throughout.

DESIGN DIRECTION PACKAGE

21-11-02 - [OMAR + MIRIAM]

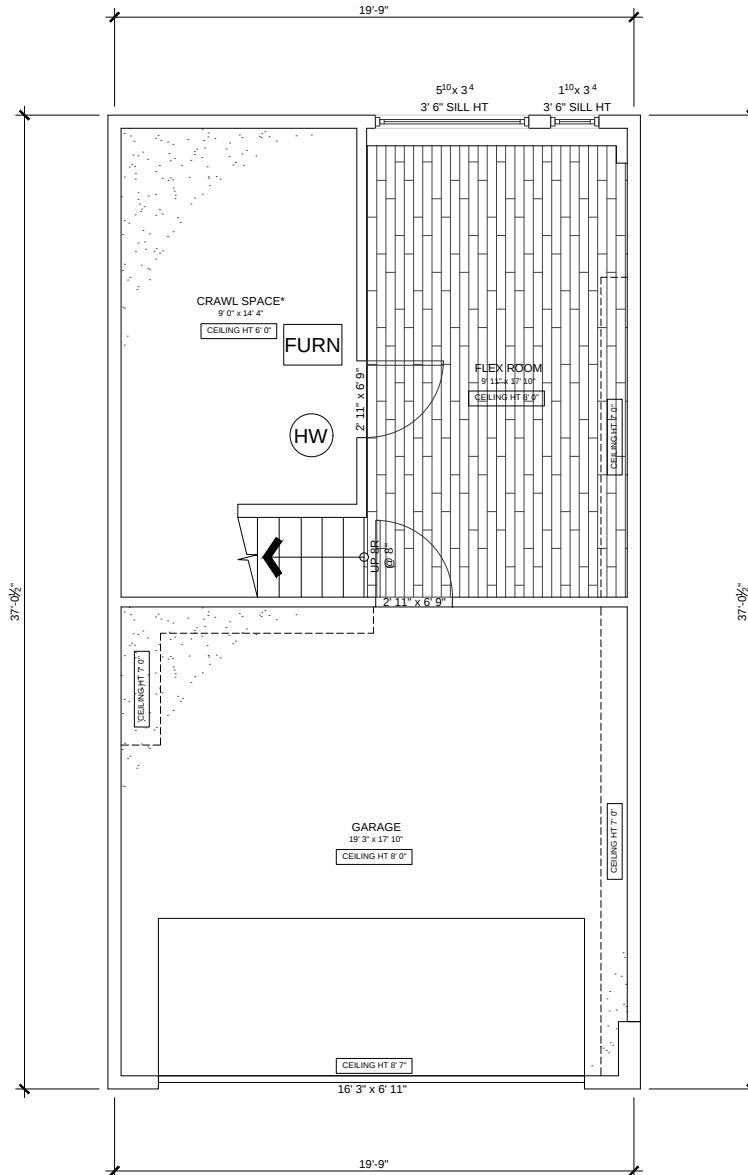

1
A201

EXISTING BELOW MAIN FLOOR PLAN

1/4" = 1'-0"


GROSS AREA

233.14 ±SQ. FT.

LEVEL 01
AS-BUILT PLANS

DESIGN DIRECTION PACKAGE

21-11-02 - [OMAR + MIRIAM]

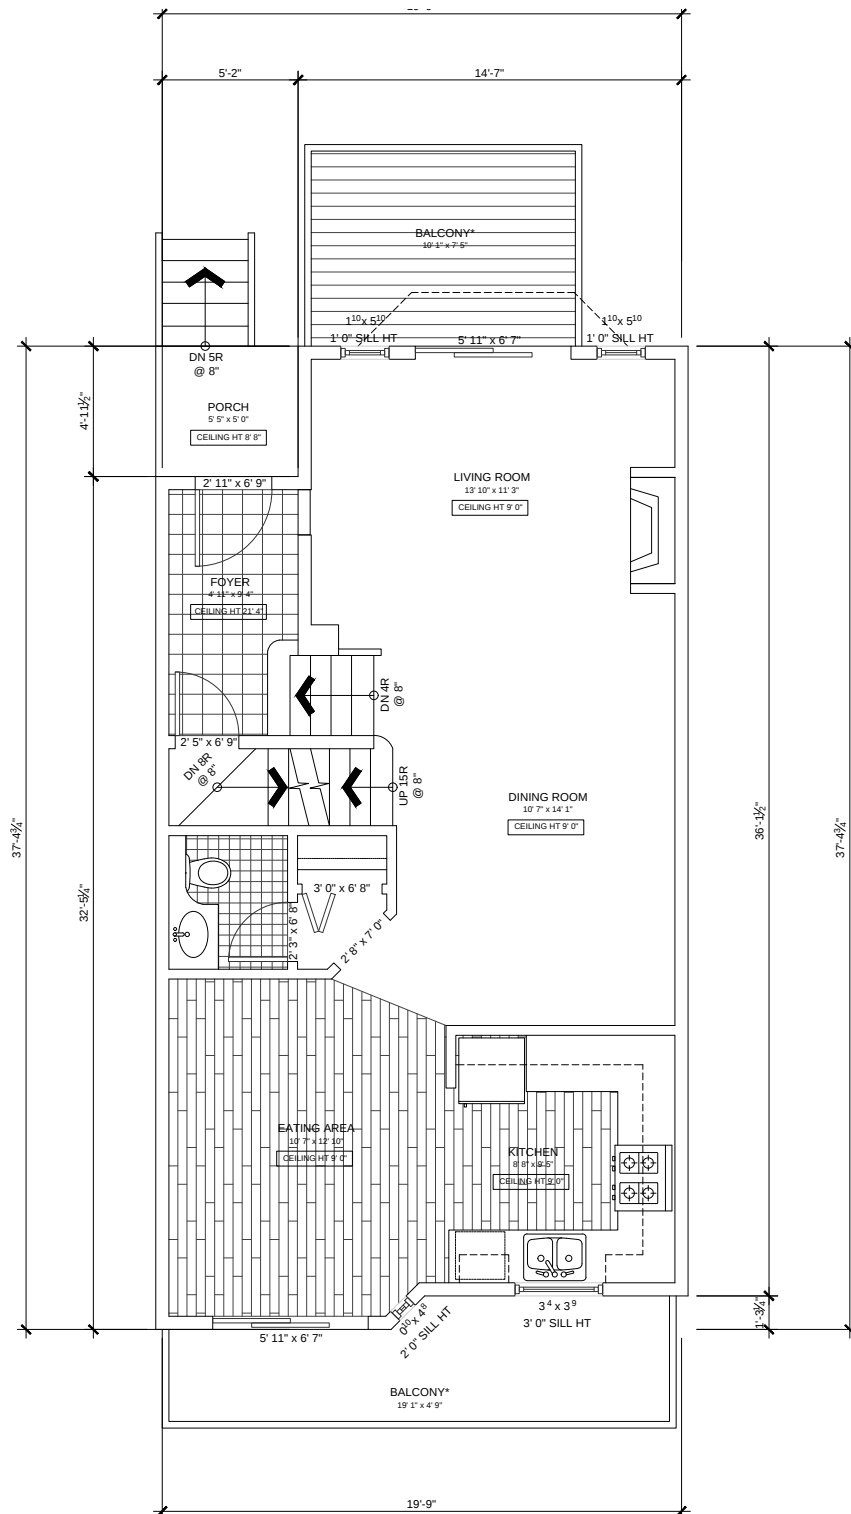


2
A201 EXISTING MAIN FLOOR PLAN
1/4" = 1'-0"

GROSS AREA

699.78 ±SQ. FT.

LEVEL 02
AS-BUILT PLANS

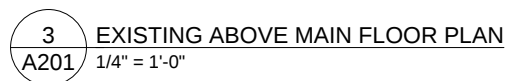

LEVEL 03

AS-BUILT PLANS

DESIGN DIRECTION PACKAGE

21-11-02 - [OMAR + MIRIAM]



KITCHEN
LEVEL 02



DESIGN DIRECTION PACKAGE

21-11-02 - [OMAR + MIRIAM]



DESIGN DIRECTION PACKAGE



21-11-02 - [OMAR + MIRIAM]



LIVING
LEVEL 02





ENSUITE | POWDER - BATHROOM
LEVEL 03 | 02 - 03

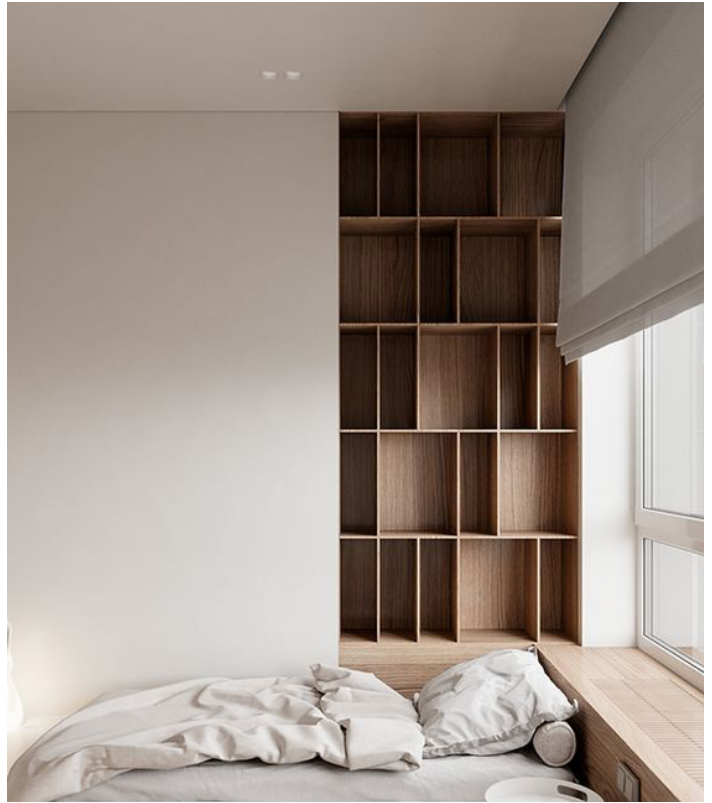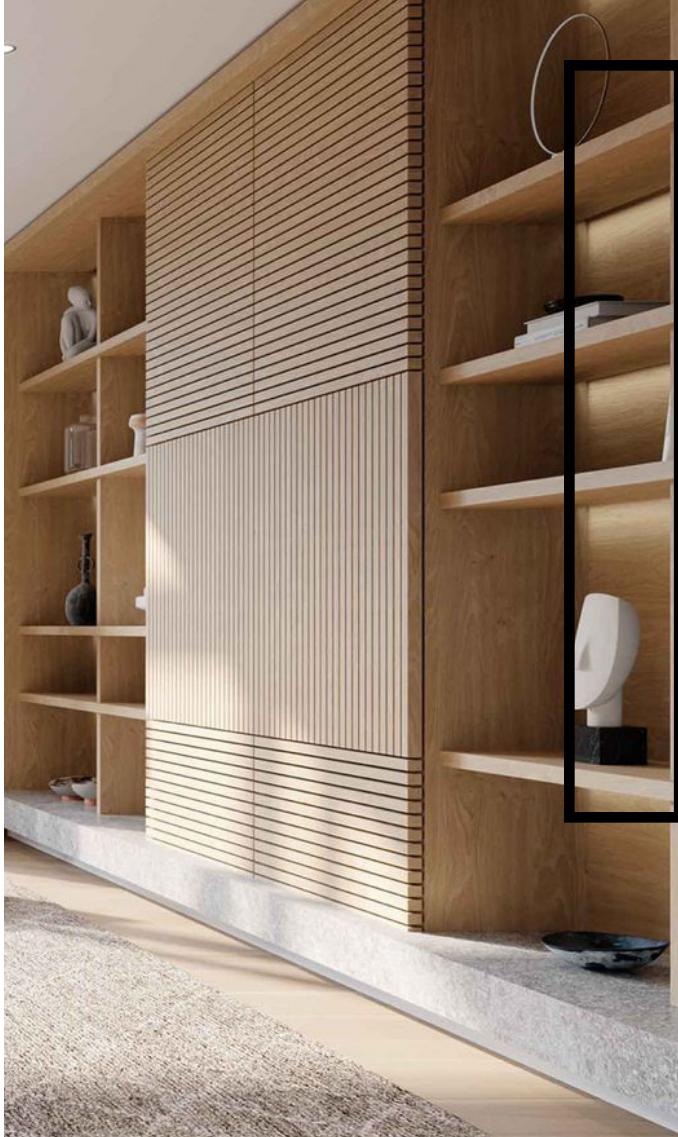

MASTER
LEVEL 03

DESIGN DIRECTION PACKAGE
21-11-02 - [OMAR + MIRIAM]

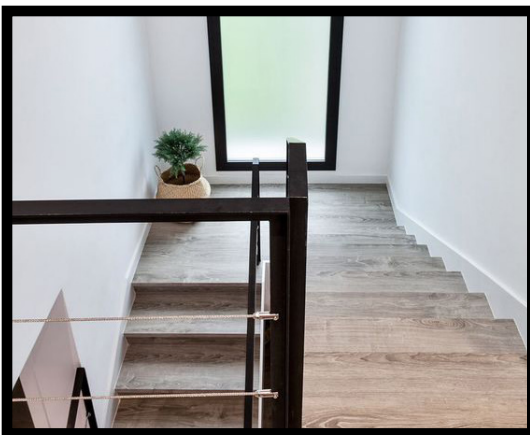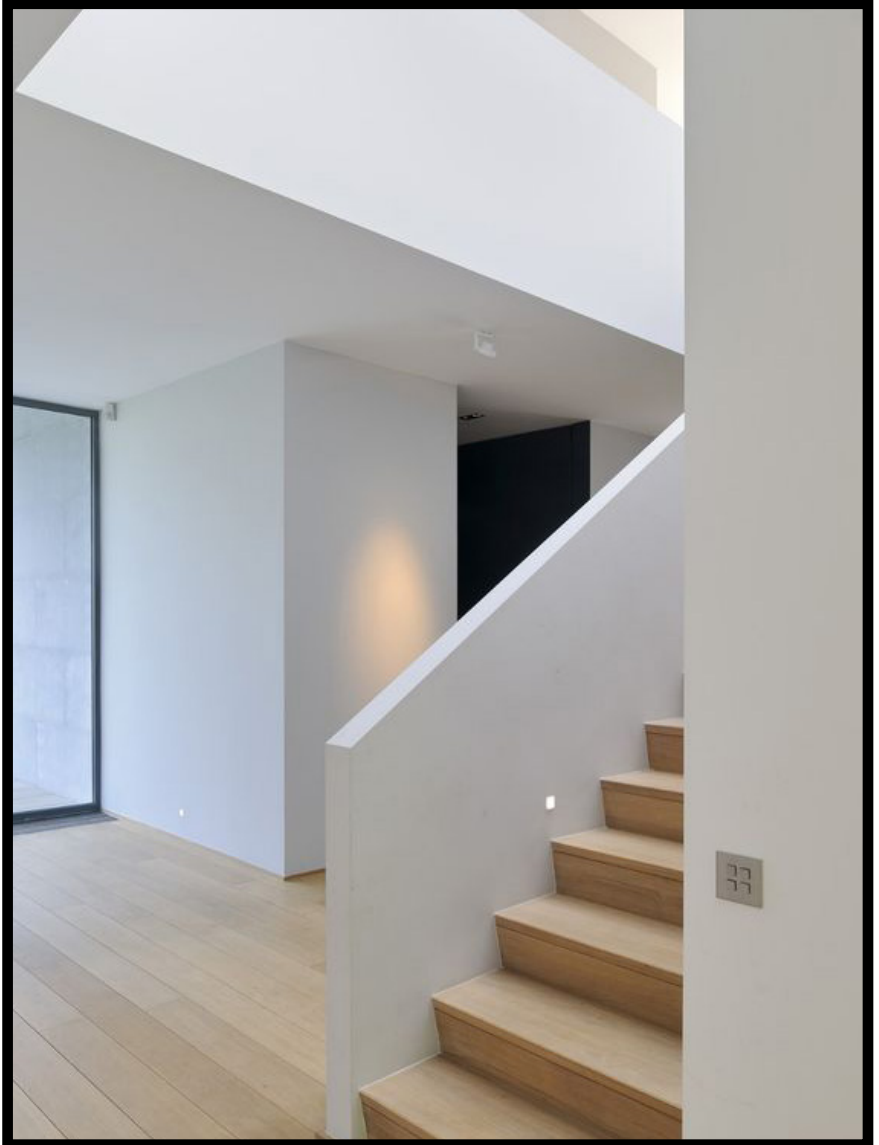

ENTRY | STAIRS
LEVEL 01 | 02 | 03