

Date	Description	Revision Number

REVISIONS

Do not scale the drawings, verify all dimensions before commencing any work. This drawing and design herein shall remain the property of the Excelsior Measuring and is not to be copied or reproduced without their written permission.



A: 20627 FRASER HWY.
LANGLEY, BC, V3A 4G4
P: 604-510-1299
E: INFO@EXCELSIORLEVEL.COM


SquareOne Contracting

CLIENT

13041 14A Ave, Surrey

PROJECT

FLOOR PLAN

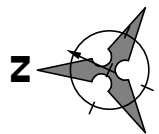

N. ARROW

R.C

DRAWN BY

22-03-24

DATE

1/4" = 1'-0"

SCALE

0001

JOB NO.

A102

SHEET

